




02	29.05.03	RE-ISSUED AS-BUILT	WA	KA	KA	DBU	DBE	AC	AJ
01	10.10.01	AS-BUILT	WA	KA	KA	DBU	DBE	AC	AJ
C1	02.07.01	APPROVED FOR CONSTRUCTION	WA	KA	KA	DBU	DBE	AC	JT
B1	20.06.01	APPROVED FOR DESIGN	WA	KA	KA	DBU	DBE	AC	JT
A2	29.03.01	RE-ISSUED FOR COMMENT	WA	KA	KA	DBU	DBE	AC	JT
A1	16.02.01	ISSUED FOR HAZOP	WA	KA	KA	DBU	DBE	AC	JT
REV	DATE	DESCRIPTION	DRN	CHK	CHK	ENG	APP	PROJ	APP
DRAWN: W.A.			TOTAL E&P UK						
DATE: 16.02.01			OTTER SUBSEA DEVELOPMENT						
SIZE: A1			TOTAL						
ENGINEERING APPROVAL			TITLE: PROCESS P & ID						
COMPANY:			ELECTRICAL, CHEMICAL INJECTION AND						
CONTRACTOR:			HYDRAULIC DISTRIBUTION SYSTEM						
SCALE: NTS			DRG. NO. OTT-U10-PR-80-0106		SHT. 01		REV: 02		

CAD FILE No. \PROJECTS\AB484\484DR0106.DWG

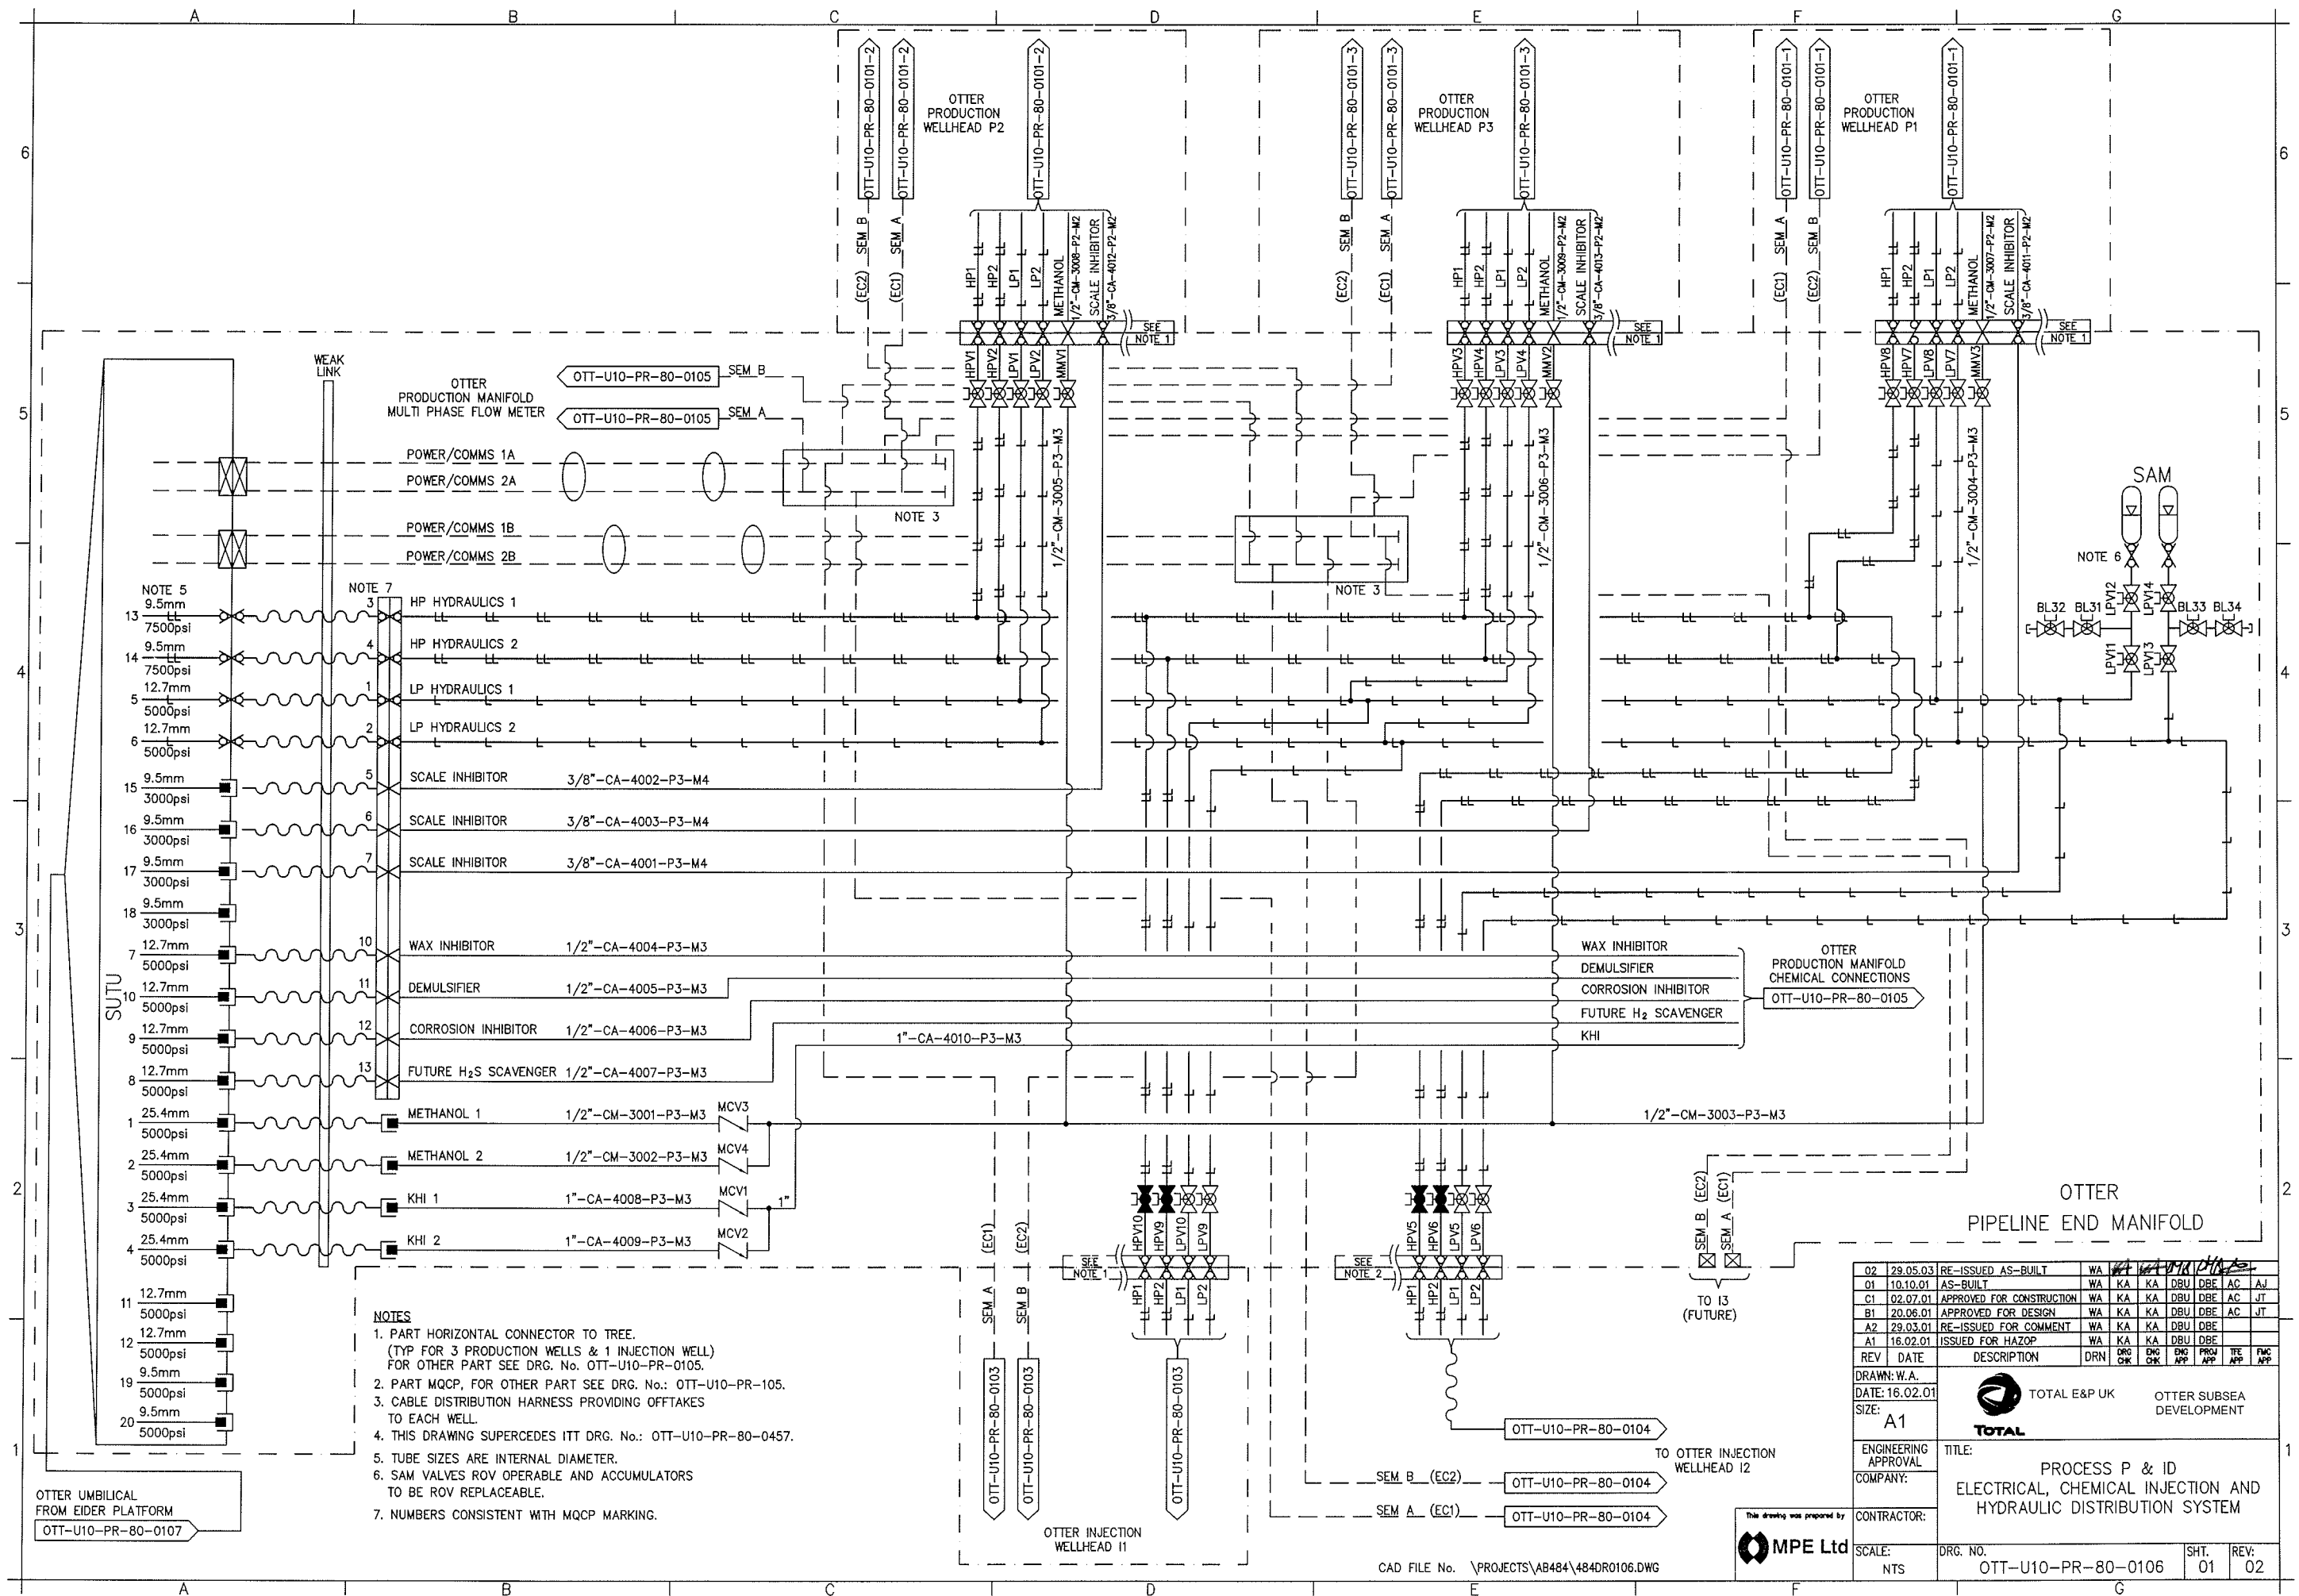