


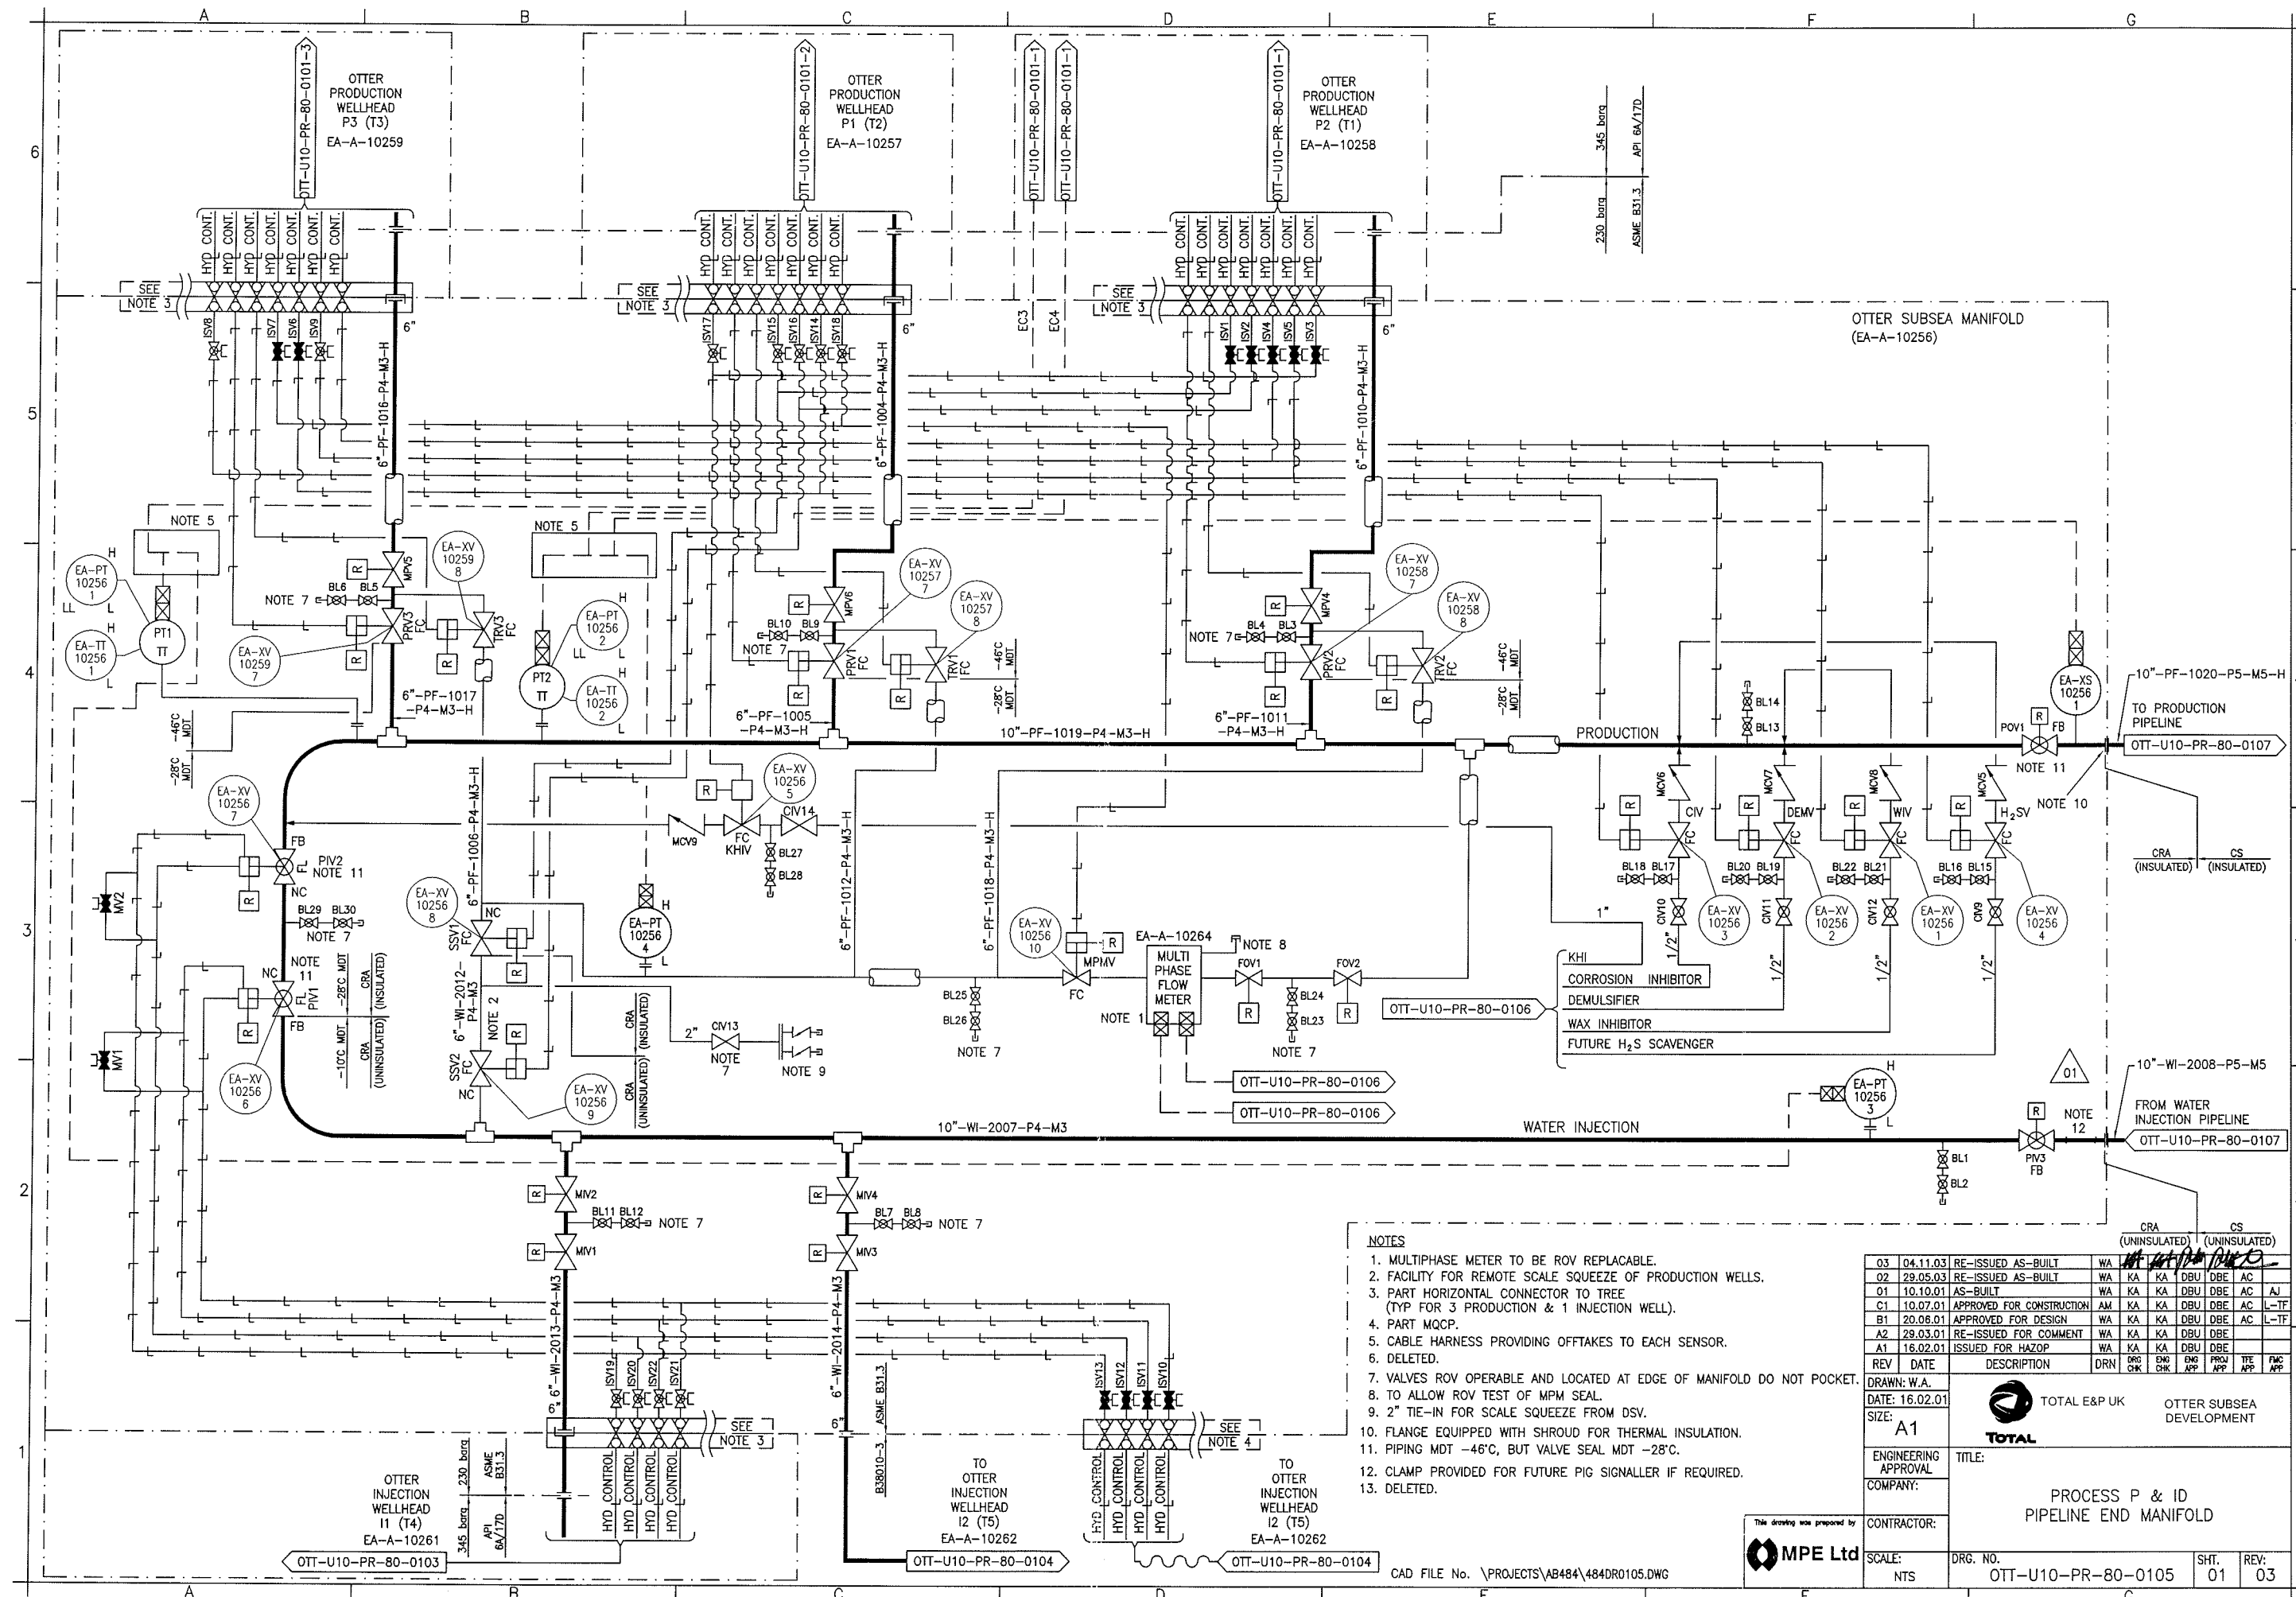

- NOTES**
- MULTIPHASE METER TO BE ROV REPLACABLE.
 - FACILITY FOR REMOTE SCALE SQUEEZE OF PRODUCTION WELLS.
 - PART HORIZONTAL CONNECTOR TO TREE (TYP FOR 3 PRODUCTION & 1 INJECTION WELL).
 - PART MQCP.
 - CABLE HARNESS PROVIDING OFFTAKES TO EACH SENSOR.
 - DELETED.
 - VALVES ROV OPERABLE AND LOCATED AT EDGE OF MANIFOLD DO NOT POCKET.
 - TO ALLOW ROV TEST OF MPM SEAL.
 - 2" TIE-IN FOR SCALE SQUEEZE FROM DSV.
 - FLANGE EQUIPPED WITH SHROUD FOR THERMAL INSULATION.
 - PIPING MDT -46°C, BUT VALVE SEAL MDT -28°C.
 - CLAMP PROVIDED FOR FUTURE PIG SIGNALLER IF REQUIRED.
 - DELETED.

REV	DATE	DESCRIPTION	DRN	ENG	APP	PROJ	ITE	FAC
03	04.11.03	RE-ISSUED AS-BUILT	WA	KA	KA	DBU	DBE	AC
02	29.05.03	RE-ISSUED AS-BUILT	WA	KA	KA	DBU	DBE	AC
01	10.10.01	AS-BUILT	WA	KA	KA	DBU	DBE	AC
C1	10.07.01	APPROVED FOR CONSTRUCTION	AM	KA	KA	DBU	DBE	AC
B1	20.06.01	APPROVED FOR DESIGN	WA	KA	KA	DBU	DBE	AC
A2	29.03.01	RE-ISSUED FOR COMMENT	WA	KA	KA	DBU	DBE	AC
A1	16.02.01	ISSUED FOR HAZOP	WA	KA	KA	DBU	DBE	AC

DRAWN: W.A. DATE: 16.02.01 SIZE: A1 ENGINEERING APPROVAL COMPANY:	 TOTAL E&P UK OTTER SUBSEA DEVELOPMENT TITLE: PROCESS P & ID PIPELINE END MANIFOLD
CONTRACTOR: SCALE: NTS DRG. NO. OTT-U10-PR-80-0105 SHT. 01 REV. 03	MPE Ltd CAD FILE No. \PROJECTS\AB484\484DR0105.DWG