


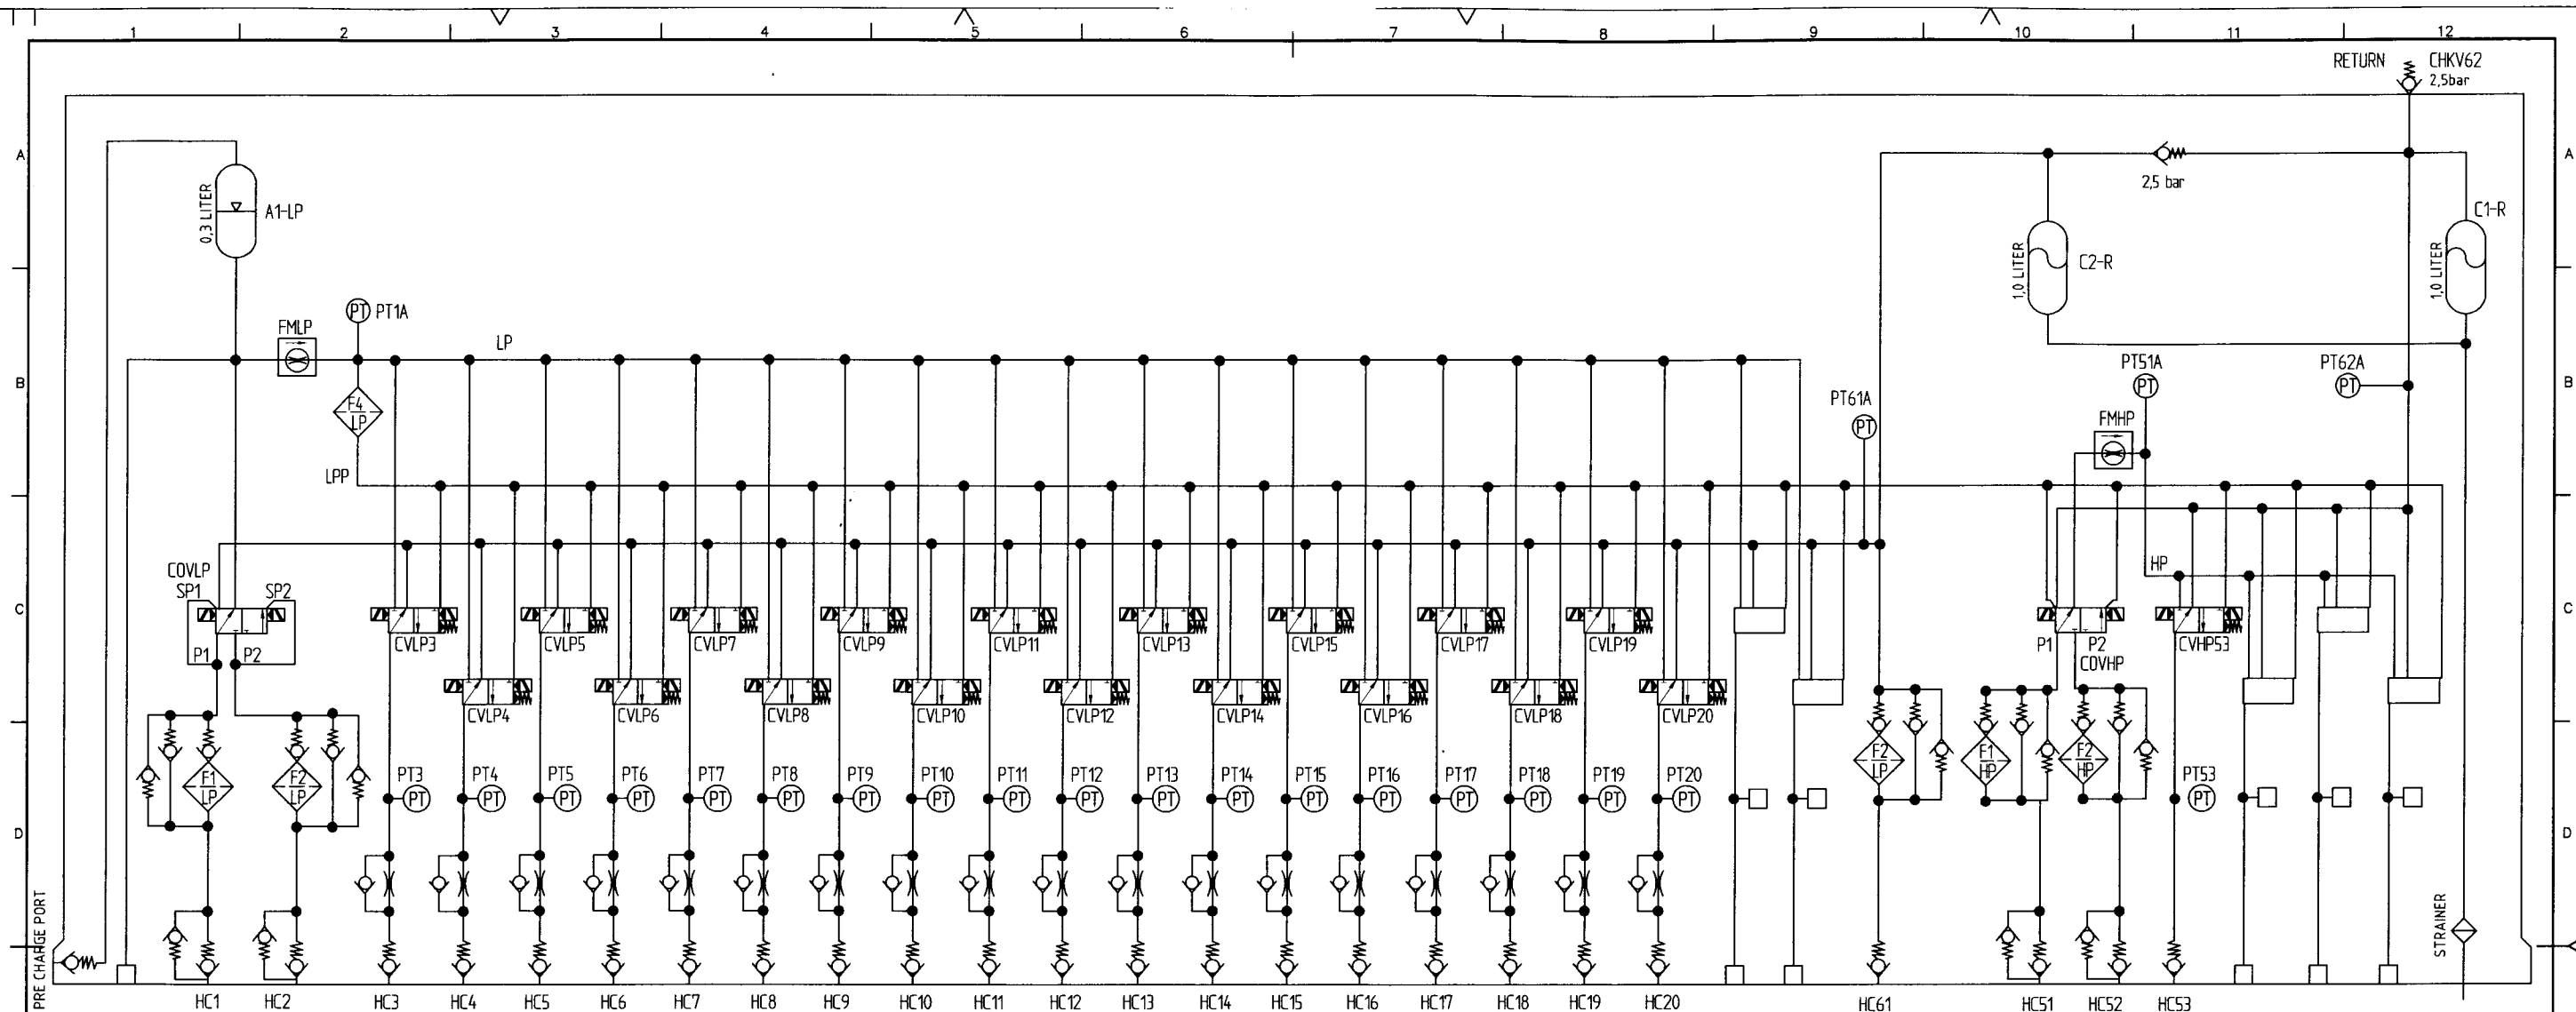

	PRODUCTION XT1	PRODUCTION XT2	PRODUCTION XT3	INJECTION XT1	INJECTION XT2
LP1 SUPPLY	LP1 SUPPLY	LP1 SUPPLY	LP1 SUPPLY	LP1 SUPPLY	LP1 SUPPLY
LP2 SUPPLY	LP2 SUPPLY	LP2 SUPPLY	LP2 SUPPLY	LP2 SUPPLY	LP2 SUPPLY
PMV	PMV	PMV	PMV	PMV	PMV
XOV	XOV	XOV	XOV	XOV	XOV
AMV	AMV	AMV	AMV	AMV	AMV
MV	MV	MV	MV	MV	MV
SIV	SIV	SIV	SIV	SIV	SIV
CV (O)	CV (O)	CV (O)	CV (O)	CV (O)	CV (O)
CV (C)	CV (C)	CV (C)	CV (C)	CV (C)	CV (C)
ESP SWITCH POS 2	ESP SWITCH POS 2	ESP SWITCH POS 2	ESP SWITCH POS 2	ESP SWITCH POS 2	ESP SWITCH POS 2
PRV	PRV	PRV	PRV	PRV	PRV
ESP SWITCH POS 1	ESP SWITCH POS 1	ESP SWITCH POS 1	ESP SWITCH POS 1	ESP SWITCH POS 1	ESP SWITCH POS 1
MPMV	MPMV	MPMV	MPMV	MPMV	MPMV
SSV1	SSV1	SSV1	SSV1	SSV1	SSV1
KHV	KHV	KHV	KHV	KHV	KHV
SSV2	SSV2	SSV2	SSV2	SSV2	SSV2
CV	CV	CV	CV	CV	CV
TRV	TRV	TRV	TRV	TRV	TRV
LP SPARE	LP SPARE	LP SPARE	LP SPARE	LP SPARE	LP SPARE
BLINDED	BLINDED	BLINDED	BLINDED	BLINDED	BLINDED
BLINDED	BLINDED	BLINDED	BLINDED	BLINDED	BLINDED
RETURN	RETURN	RETURN	RETURN	RETURN	RETURN
HP1 SUPPLY	HP1 SUPPLY	HP1 SUPPLY	HP1 SUPPLY	HP1 SUPPLY	HP1 SUPPLY
HP2 SUPPLY	HP2 SUPPLY	HP2 SUPPLY	HP2 SUPPLY	HP2 SUPPLY	HP2 SUPPLY
SCSSV	SCSSV	SCSSV	SCSSV	SCSSV	SCSSV
BLINDED	BLINDED	BLINDED	BLINDED	BLINDED	BLINDED
BLINDED	BLINDED	BLINDED	BLINDED	BLINDED	BLINDED
BLINDED	BLINDED	BLINDED	BLINDED	BLINDED	BLINDED

LEGEND:

HYDRAULIC COUPLER
 BLADDER COMPENSATOR
 ACCUMULATOR

HYDRAULIC FLOW METER
 BLIND PLUG
 RESTRICTOR

PRESSURE TRANSDUCER
 BLIND PLATE
 FILTER
 CHECK VALVE CRACKING PRESSURE 1 - 25 BAR

SUPPLY CHANGE-OVER VALVE
 3/2 NORMALLY CLOSED CONTROL VALVE
 BY PASS SYSTEM

NOTE:
2 mm RESTRICTOR ON ALL LP FUNCTION LINES EXCEPT FOR CHOKE LINES.
1 mm RESTRICTOR ON CHOKE LINES CV (O) AND CV (C).

TOTAL FINA ELF

OTT-U10-PT-80-1124

DESIGNER: Magnus Nygård

LAST SAVED (DATE/TIME): 10.10.2002 12:15

NO. OF REV: 01

SCALE: 1:1

SIZE: A1

DRAWING NO: XV-0001000105

WEIGHT: SHEET 1 OF 1

01 10.10.02 AS BUILT MANY BTN BTN JTT

REV. DATE DESCRIPTION DWN DRG ENG ENG PROI TFEUK APP

500000016736

REL/CHANGE NO. DESIGNER

UNLESS OTHERWISE SPECIFIED DIM TOL. ROUGHNESS FILLET RAD. BROKEN EDGES THREAD TOLERANCE

THIS DRAWING IS THE PROPERTY OF FMC Kongsberg Subsea AS and shall neither be copied nor presented to non authorized persons without the written consent of FMC Kongsberg Subsea AS

HYDRAULIC SCHEMATIC

SCM

TOTAL FINA - OTTER