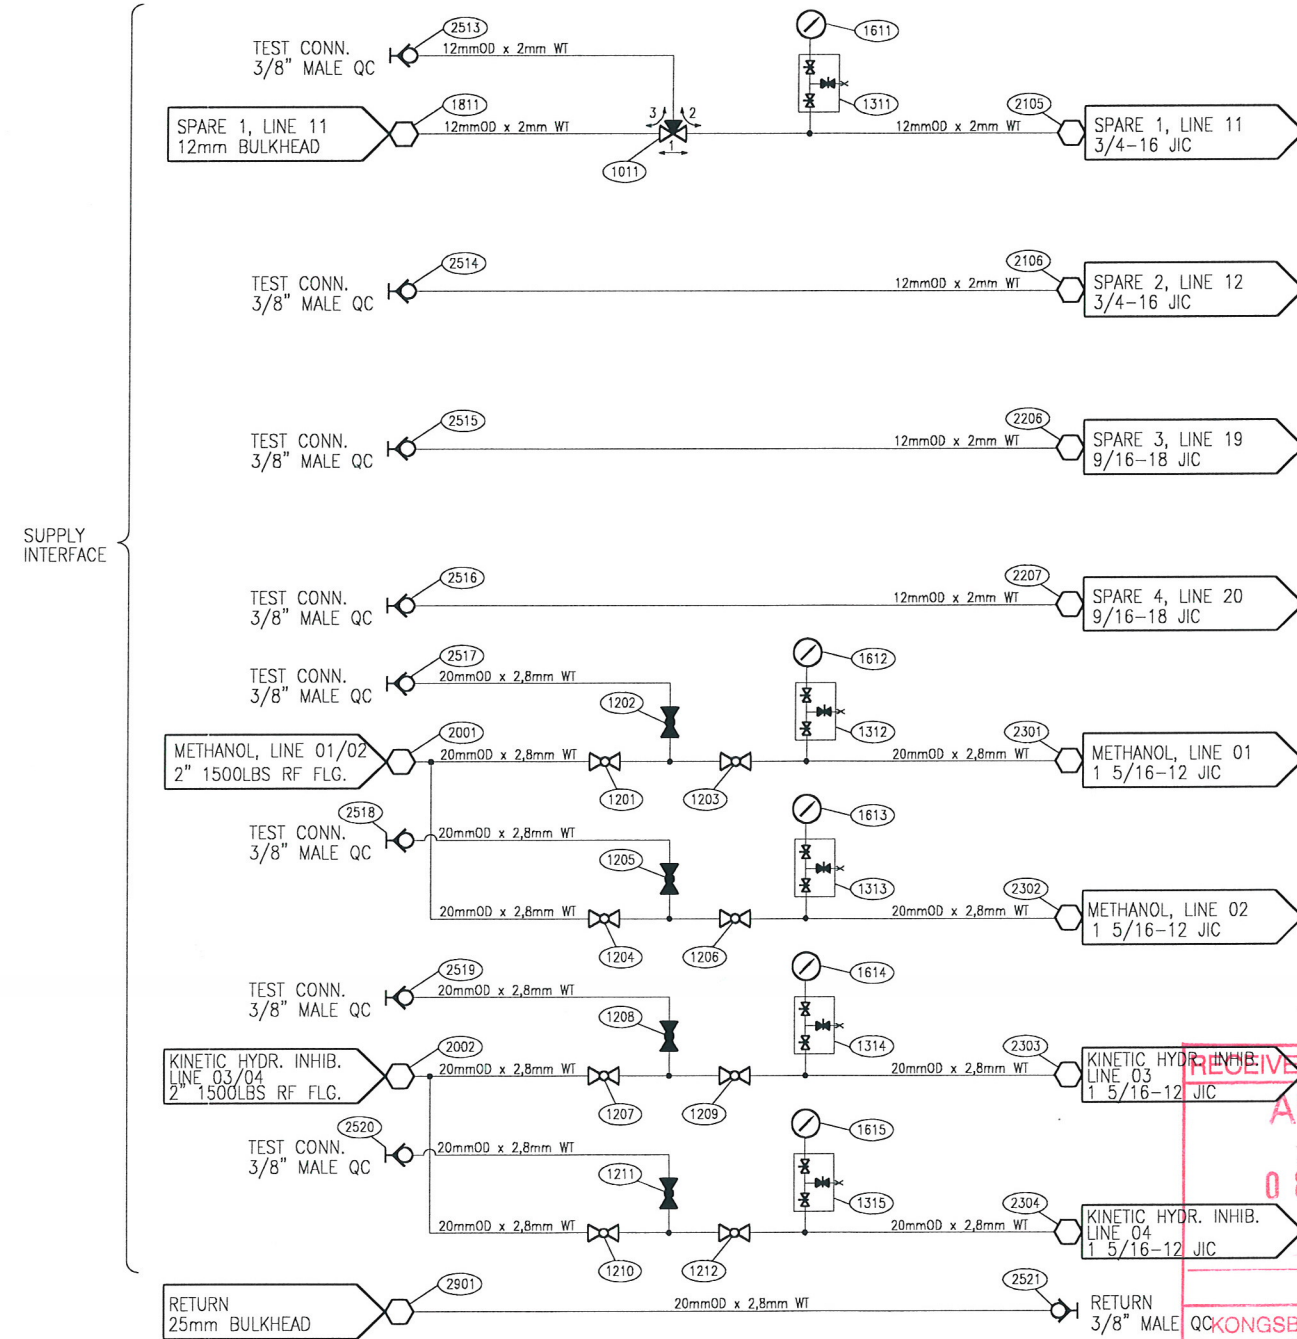
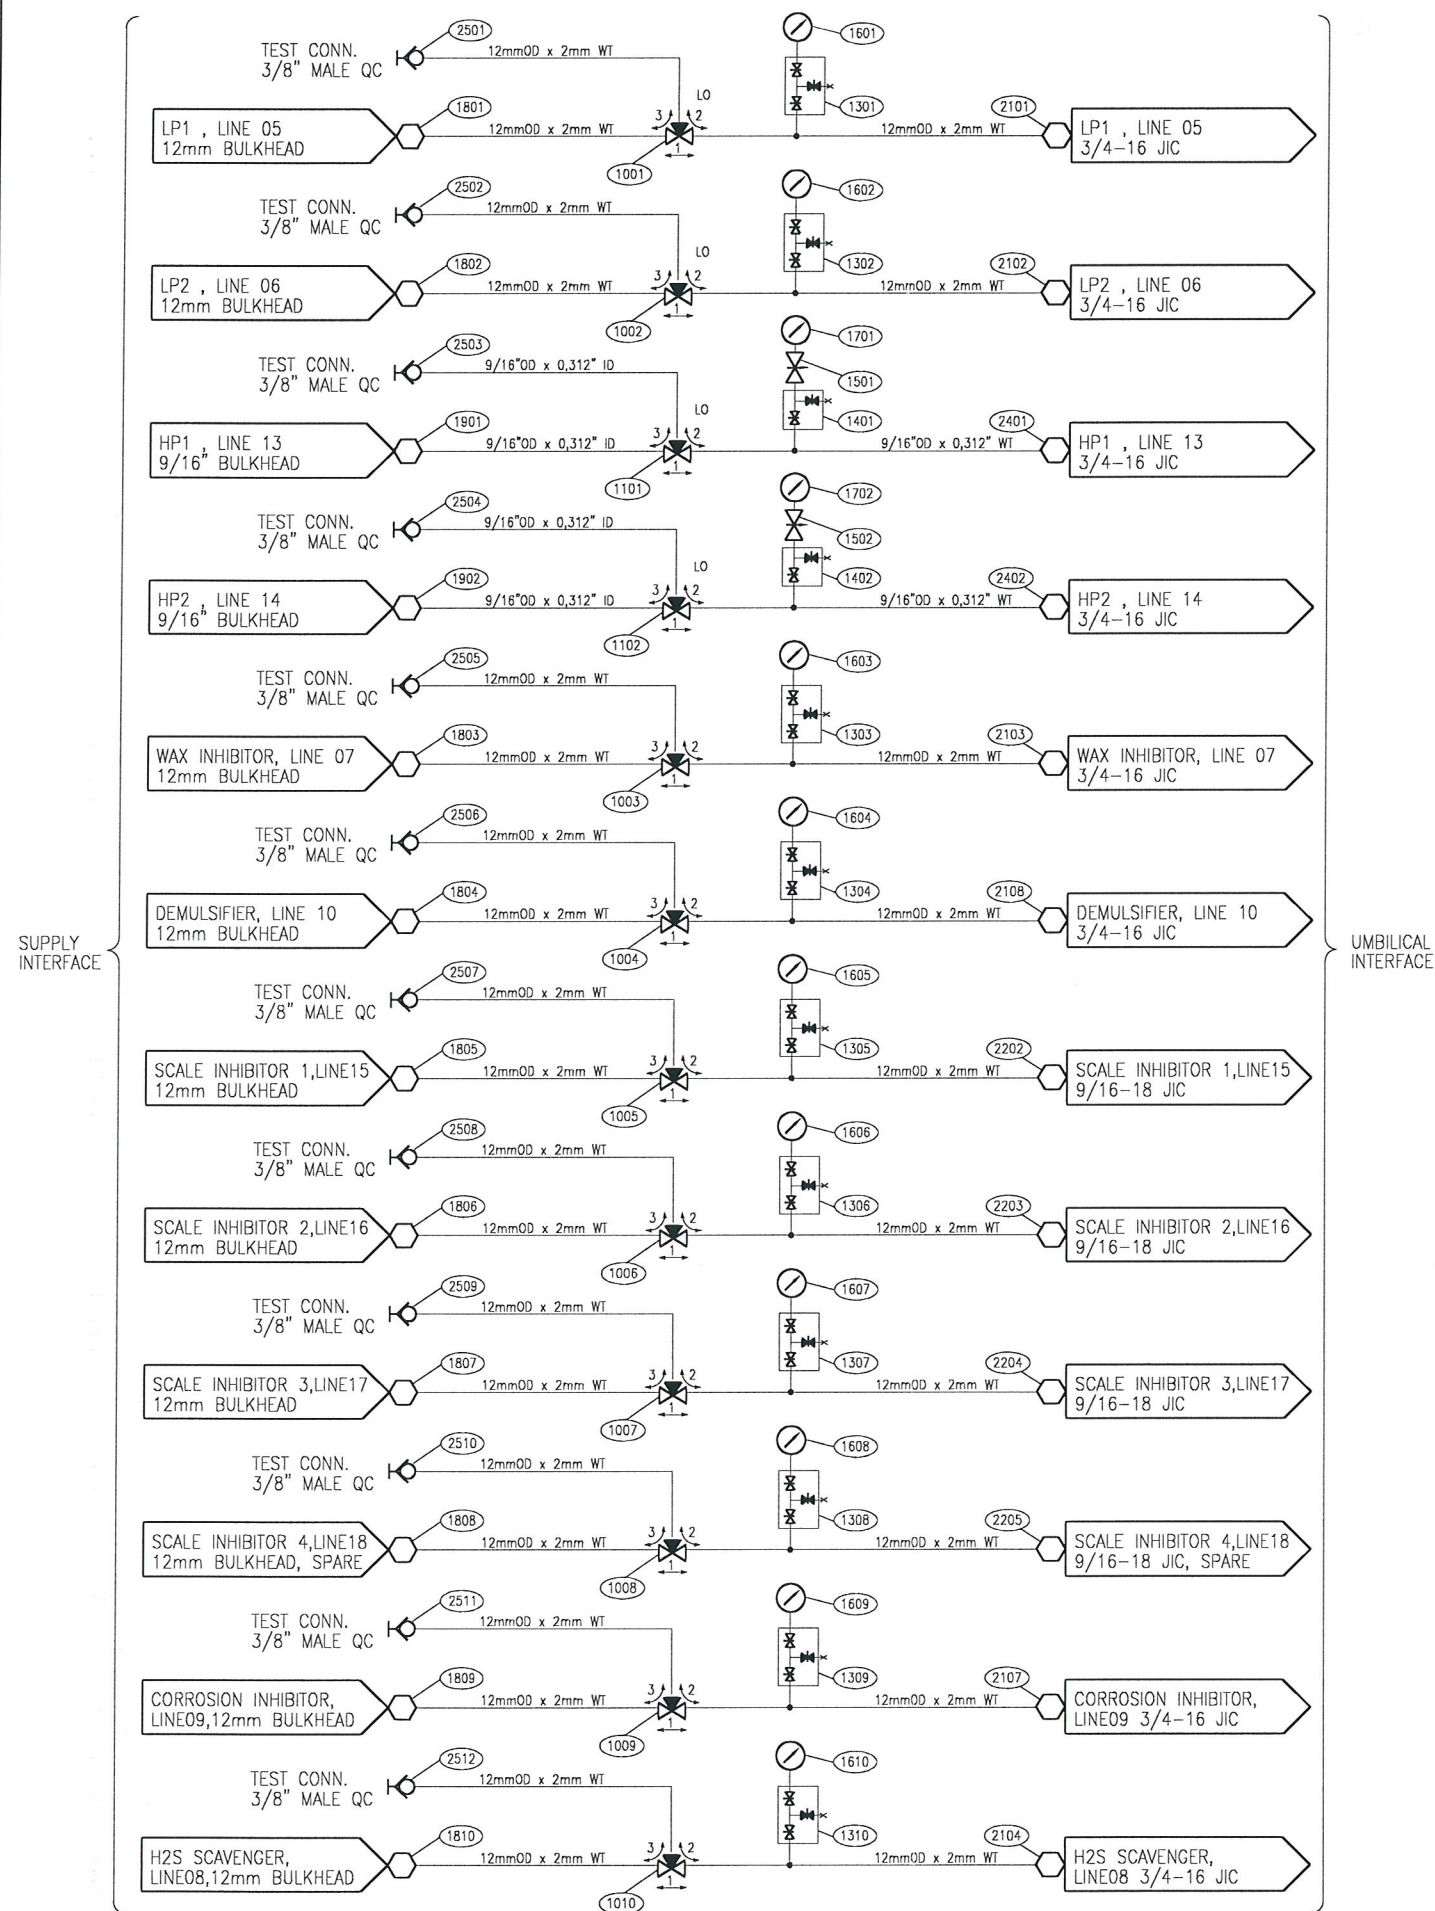


ABBREVIATIONS:
LO - LOCKED OPEN

- NOTES:**
- REFERENCES:

DESIGN SPEC	: SPC-0000020466
BILL OF MATERIAL	: 7639-A01-003/LIST-0000020239
G.A. INTERFACE & ENVELOPE	: 7639-E01-001/XD-0001000573
GENERAL ARRANGEMENT DRAWING	: 7639-E01-002/XD-0001000540
WIRING DIAGRAM	: 7639-F03-001/XK-0001000118
P & ID	: 7639-I01-001/XB-0001000089

500000008365	Magnus Nygård	01.11.2001 09:05	B
REL./CHANGE NO.	PREPARED	LAST SAVED (DATE/TIME)	REV.
FMC EnergySystems FMC Kongsberg Subsea		DRAWING NO. XV-0001000136	
TITLE: TUTU Hydraulic schematic - Otter			
SHEET 1 OF 1			

ABO 16.10.01	AS-BUILT	KH	OB	PO
04 09.04.01	ISSUED FOR CONSTRUCTION	KH	Ø0	OB
03 21.08.01	REISSUED FOR APPROVAL	KH	Ø0	OB
02 08.08.01	REISSUED FOR APPROVAL	KH	PO	JRJ
01 28.06.01	ISSUED FOR APPROVAL	SMK	PO	JRJ
Rev.	Date	Issue Description	Prep.	Chkd
Customer: FMC KONGSBERG SUBSEA			First Angle Projection	Scale
Project: OTTER			All dim. in mm	

		Semco Technology a.s. Fabrikkeveien 25, 4065 Stavanger Tel. 51811200 Fax. 51811201																																	
Drawing Title		HYDRAULIC SCHEMATIC DIAGRAM TUTU																																	
Drawing Size		A1						Dwg No.		7639-D02-001				Sheet		of		Rev.																	
														01		01		AB																	
01		01.11.01						AS BUILT				SEM		TOHA		TOHA		JTT		JTT															
REV.		DATE						DESCRIPTION				DRN		DRG CHK		ENG CHK		ENG APP		PROJ APP		TFEE APP													
TOTAL FINA ELF																																			
DRG NO.												OTT-U10-PT-80-1085										Contractor										SHT		REV.	
																																01		01	

OTHER	NAME
DBE	
DBU	
BY	
QC	
BB	
AN	
MO	
MC	
KA	
GL-PE/PRO	
HC-WCM/DEX	
HH-WCM/DEX	
AMC-WCM/DEX	
PE/PRO	
TS/EMPL	
SAFETY	
DEGP	
HM-CD/LN	
IMC	
CSO	
SHELL	
CENT	

UMBILICAL INTERFACE

RECEIVED: *Chen*
AS BUILT
08 NOV. 2001
SIGN. *M*
KONGSBERG OFFSHORE