




01	30.07.02	AS-BUILT	WA						
C1	17.08.01	APPROVED FOR CONSTRUCTION	WA	KA	KA	DBU	DEE	AC	EL
B1	20.08.01	APPROVED FOR DESIGN	WA	KA	KA	DBU	DEE	AC	EL
A2	20.03.01	RE-ISSUED FOR COMMENT	WA	KA	KA	DBU	DEE		
A1	18.02.01	ISSUED FOR HAZOP	WA	KA	KA	DBU	DEE		
REV	DATE	DESCRIPTION	DRN	DRP	ENG	ENG	PRG	TRF	RMK
DRAWN: W.A.			TOTALFINAELF OTTER SUBSEA DEVELOPMENT						
DATE: 18.02.01									
SIZE: A1									
ENGINEERING APPROVAL			TITLE: PROCESS P & ID I2 (T05) WATER INJECTION WELLHEAD						
COMPANY:									
CONTRACTOR:			SCALE: NTS OTT-U10-PR-80-0104						
			DRG. NO.				SHT. 01	REV: 01	

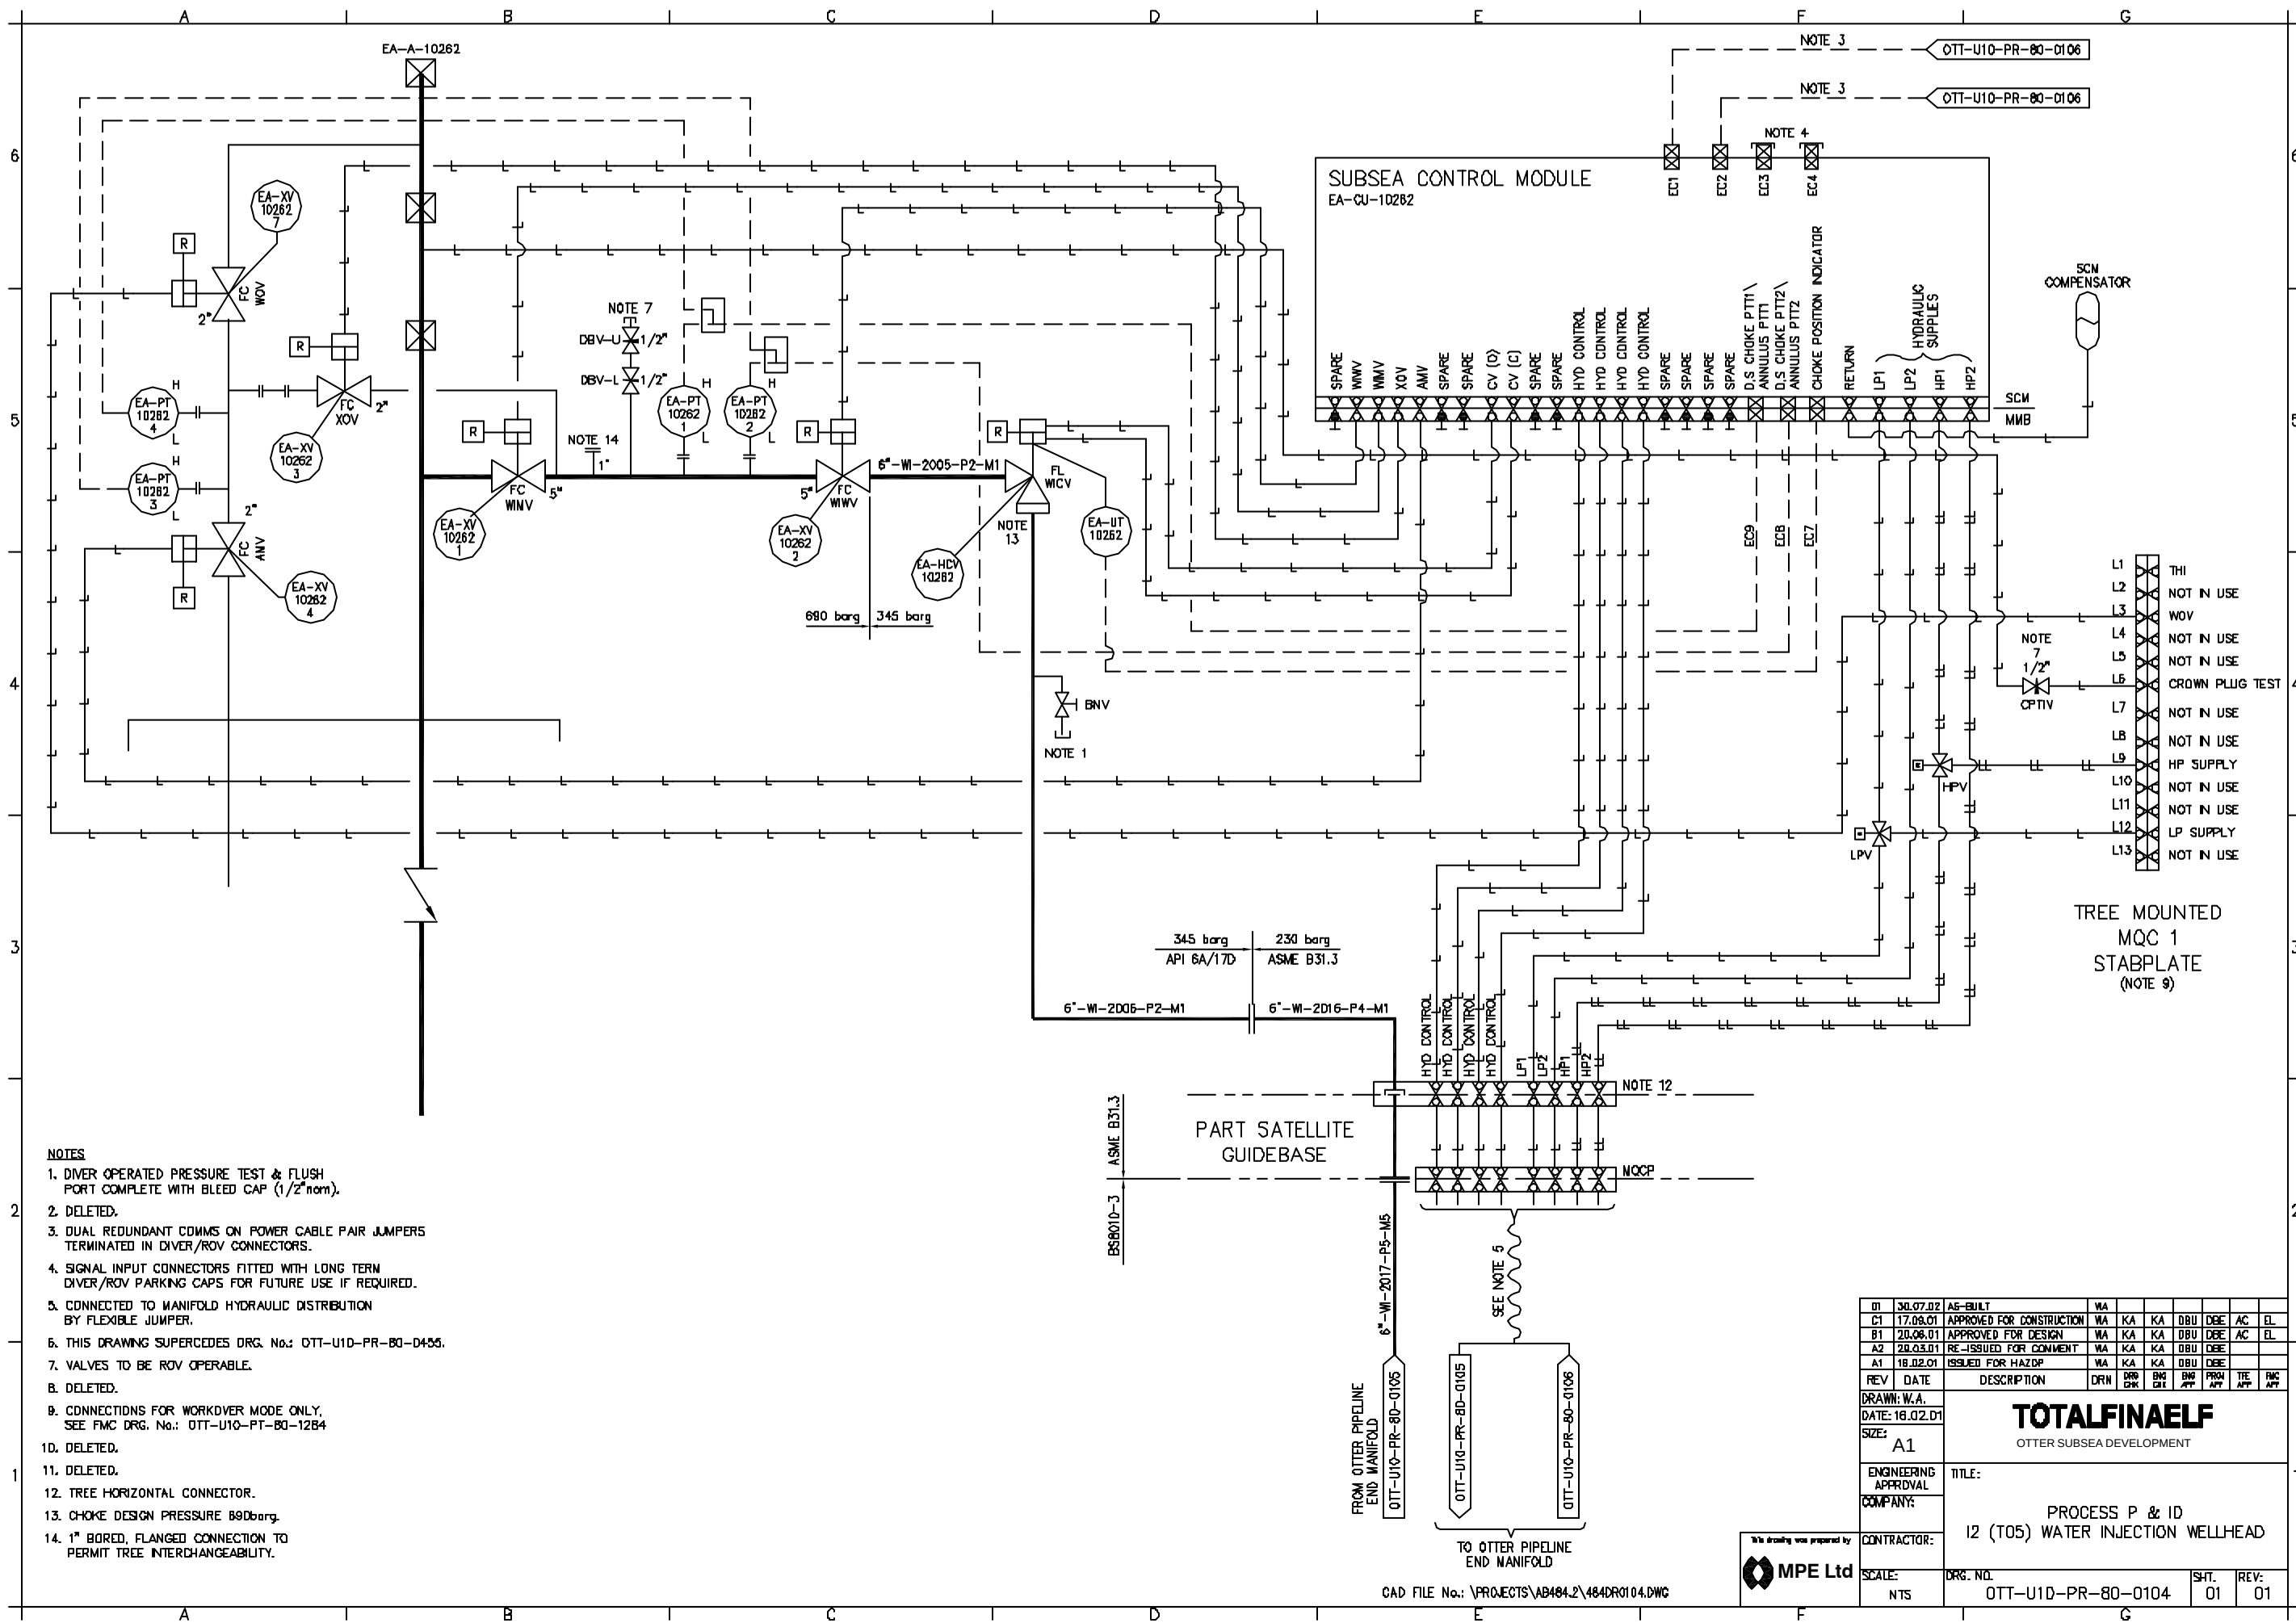

CAD FILE No.: \PROJECTS\AB484.2\484DR0104.DWG