


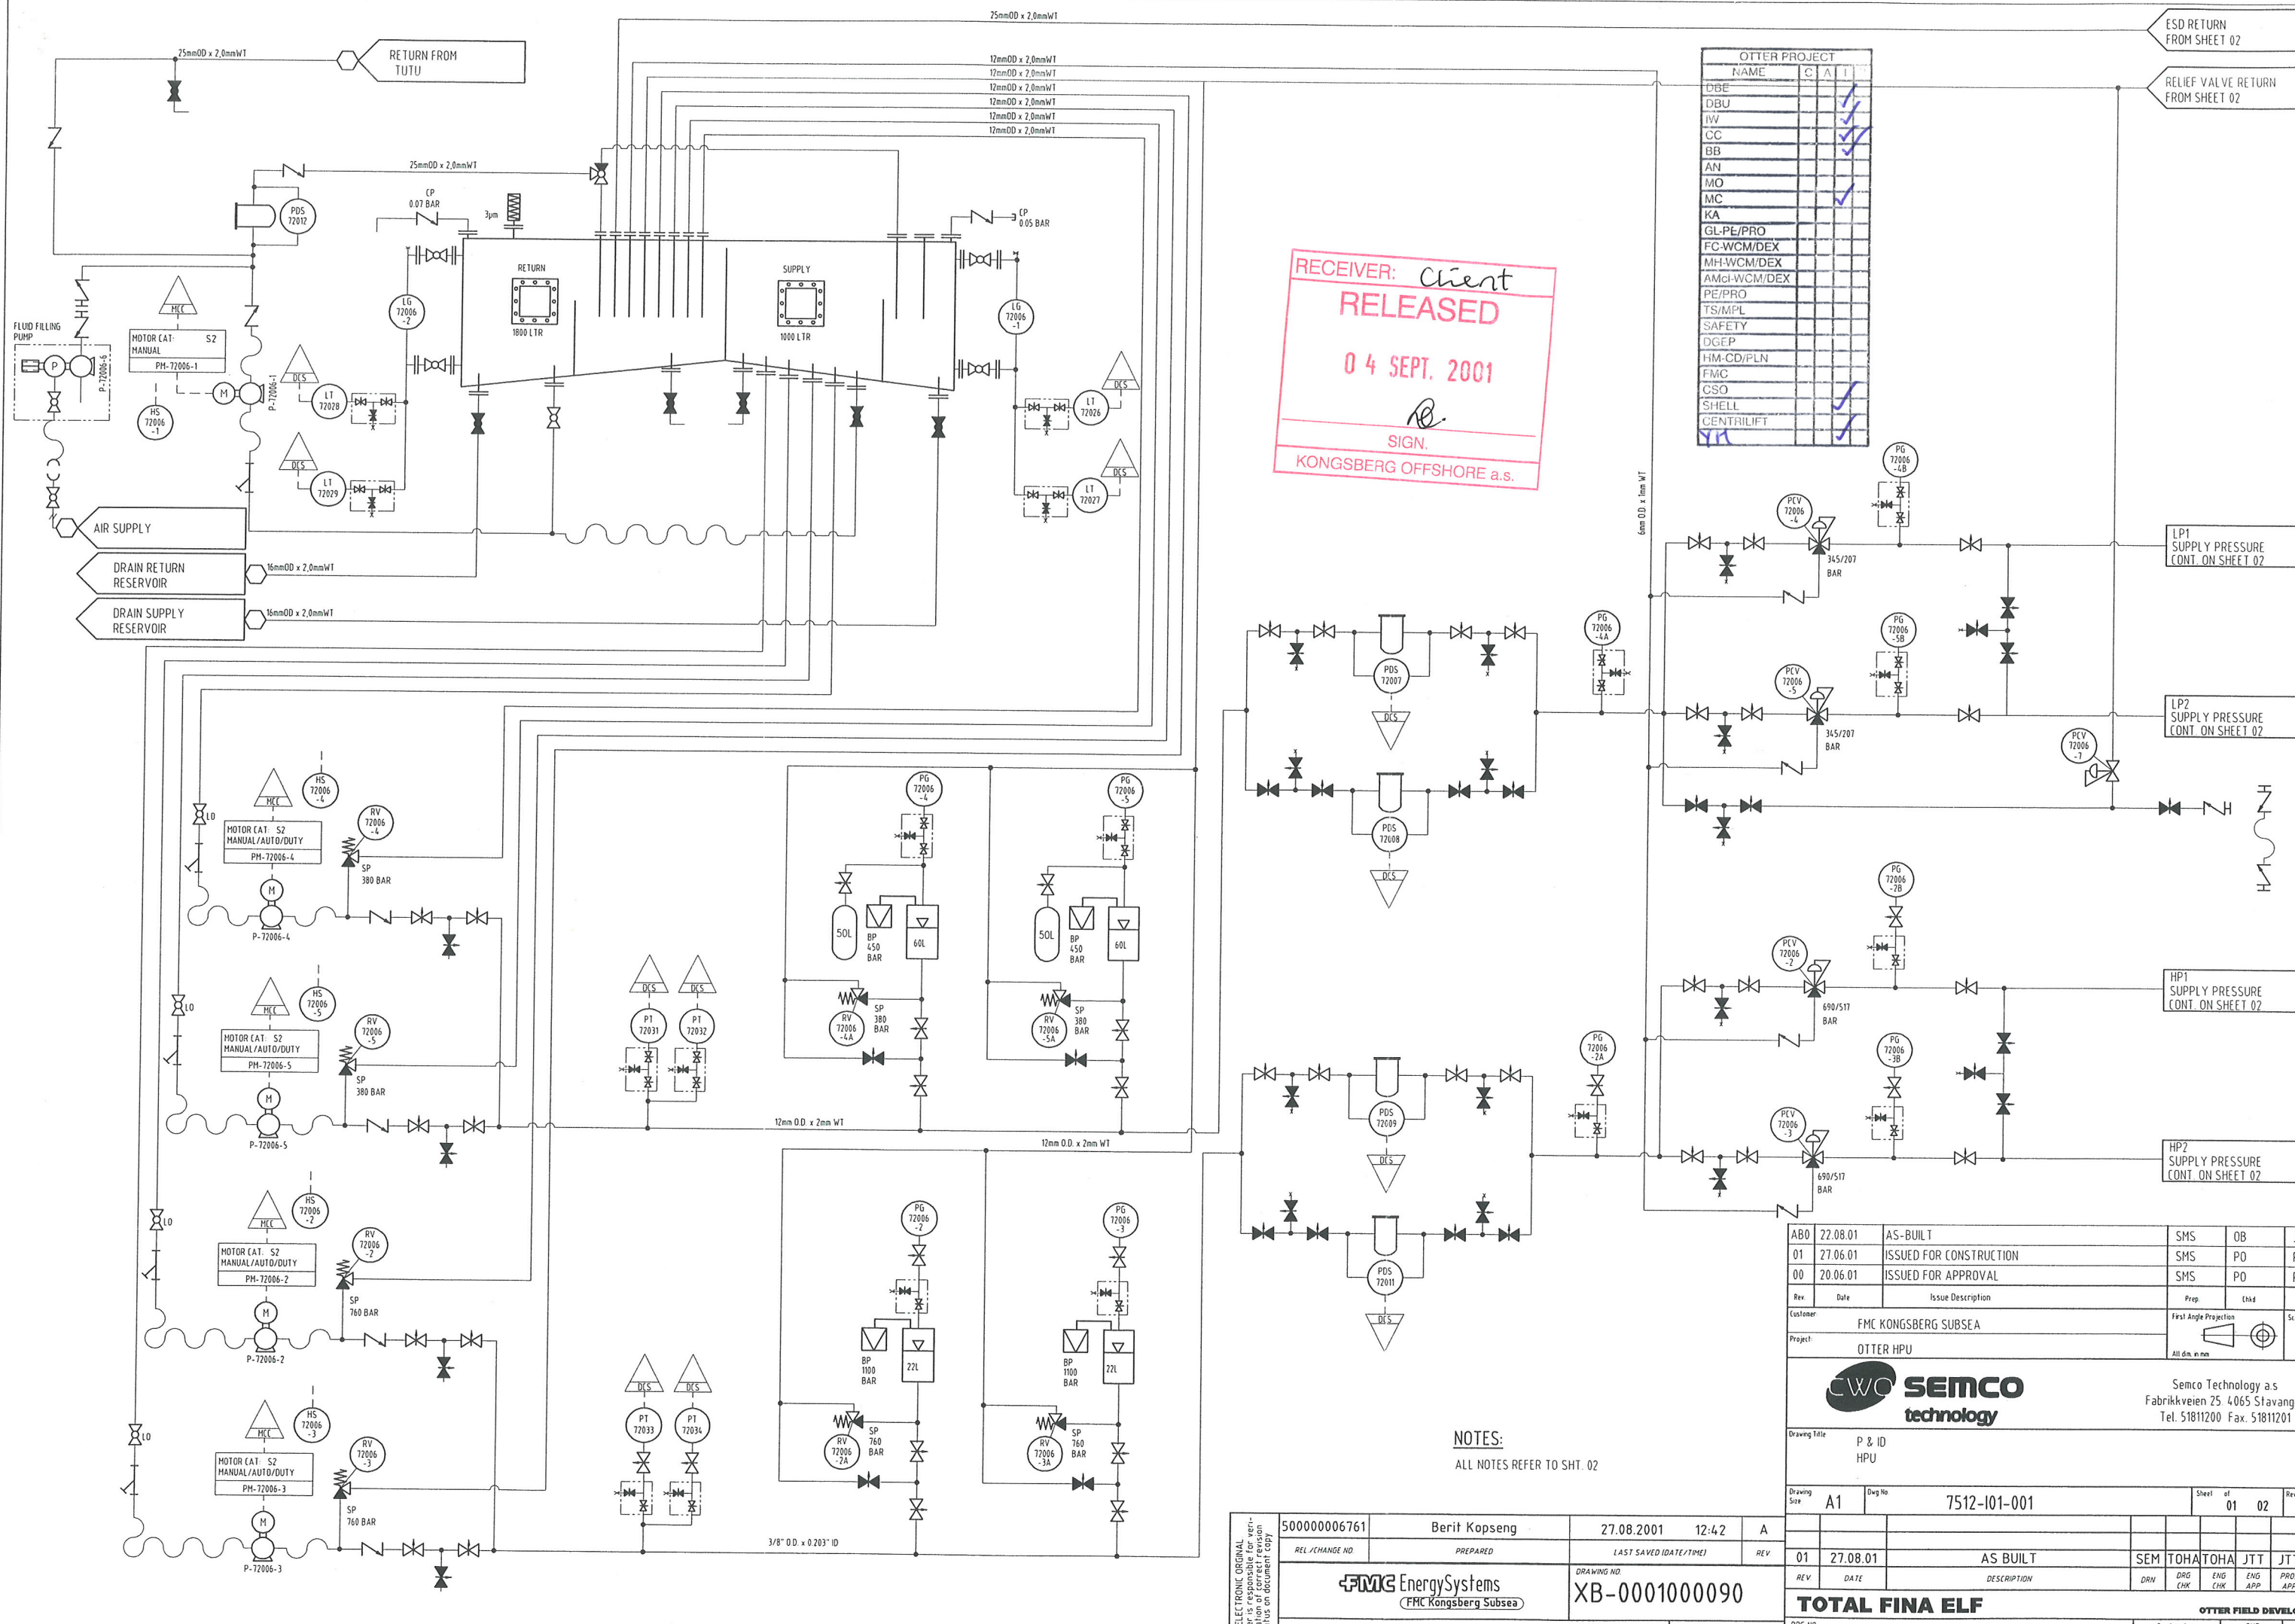

RECEIVED: Client
RELEASED
04 SEPT. 2001
SIGN.
KONGSBERG OFFSHORE a.s.

OTTER PROJECT			
NAME	C	A	I
DBE			
DBU			
IVV			
CC			
BB			
AN			
MO			
MC			
KA			
GL-PE/PRO			
FC-WCM/DEX			
MH-WCM/DEX			
AMCI-WCM/DEX			
PE/PRO			
TS/MPL			
SAFETY			
DGEP			
HM-CD/PLN			
FMC			
CSO			
SHELL			
CENTRILIFT			

ESD RETURN
FROM SHEET 02

RELIEF VALVE RETURN
FROM SHEET 02

LP1 SUPPLY PRESSURE
CONT. ON SHEET 02

LP2 SUPPLY PRESSURE
CONT. ON SHEET 02


HP1 SUPPLY PRESSURE
CONT. ON SHEET 02

HP2 SUPPLY PRESSURE
CONT. ON SHEET 02

NOTES:
ALL NOTES REFER TO SHT. 02

AB0	22.08.01	AS-BUILT	SMS	OB	JRJ
01	27.06.01	ISSUED FOR CONSTRUCTION	SMS	PO	RH
00	20.06.01	ISSUED FOR APPROVAL	SMS	PO	RH
Rev	Date	Issue Description	Prep	Chkd	Appr
Customer FMC KONGSBERG SUBSEA			First Angle Projection		Scale
Project OTTER HPU					-
			Semco Technology a.s Fabrikkveien 25 4065 Stavanger Tel. 51811200 Fax. 51811201		
Drawing Title P & ID HPU					
Drawing Size A1	Dwg No 7512-I01-001		Sheet of 01 02		Rev AB0
01	27.08.01	AS BUILT	SEM	TOHA	TOHA
REV	DATE	DESCRIPTION	DRN	ENG CHK	ENG CHK
TOTAL FINA ELF			ENG APP	PROJ APP	TFEU APP
DRG NO OTT-U10-PT-80-1068			OTTER FIELD DEVELOPMENT		
			Contractor	SHT 01	REV 01

500000006761	Berit Kopseng	27.08.2001	12:42	A
REL / CHANGE NO	PREPARED	LAST SAVED (DATE/TIME)		
FMC Energy Systems (FMC Kongsberg Subsea)		DRAWING NO: XB-0001000090		
TITLE: HPU P&ID - Otter		SHEET 01	2	

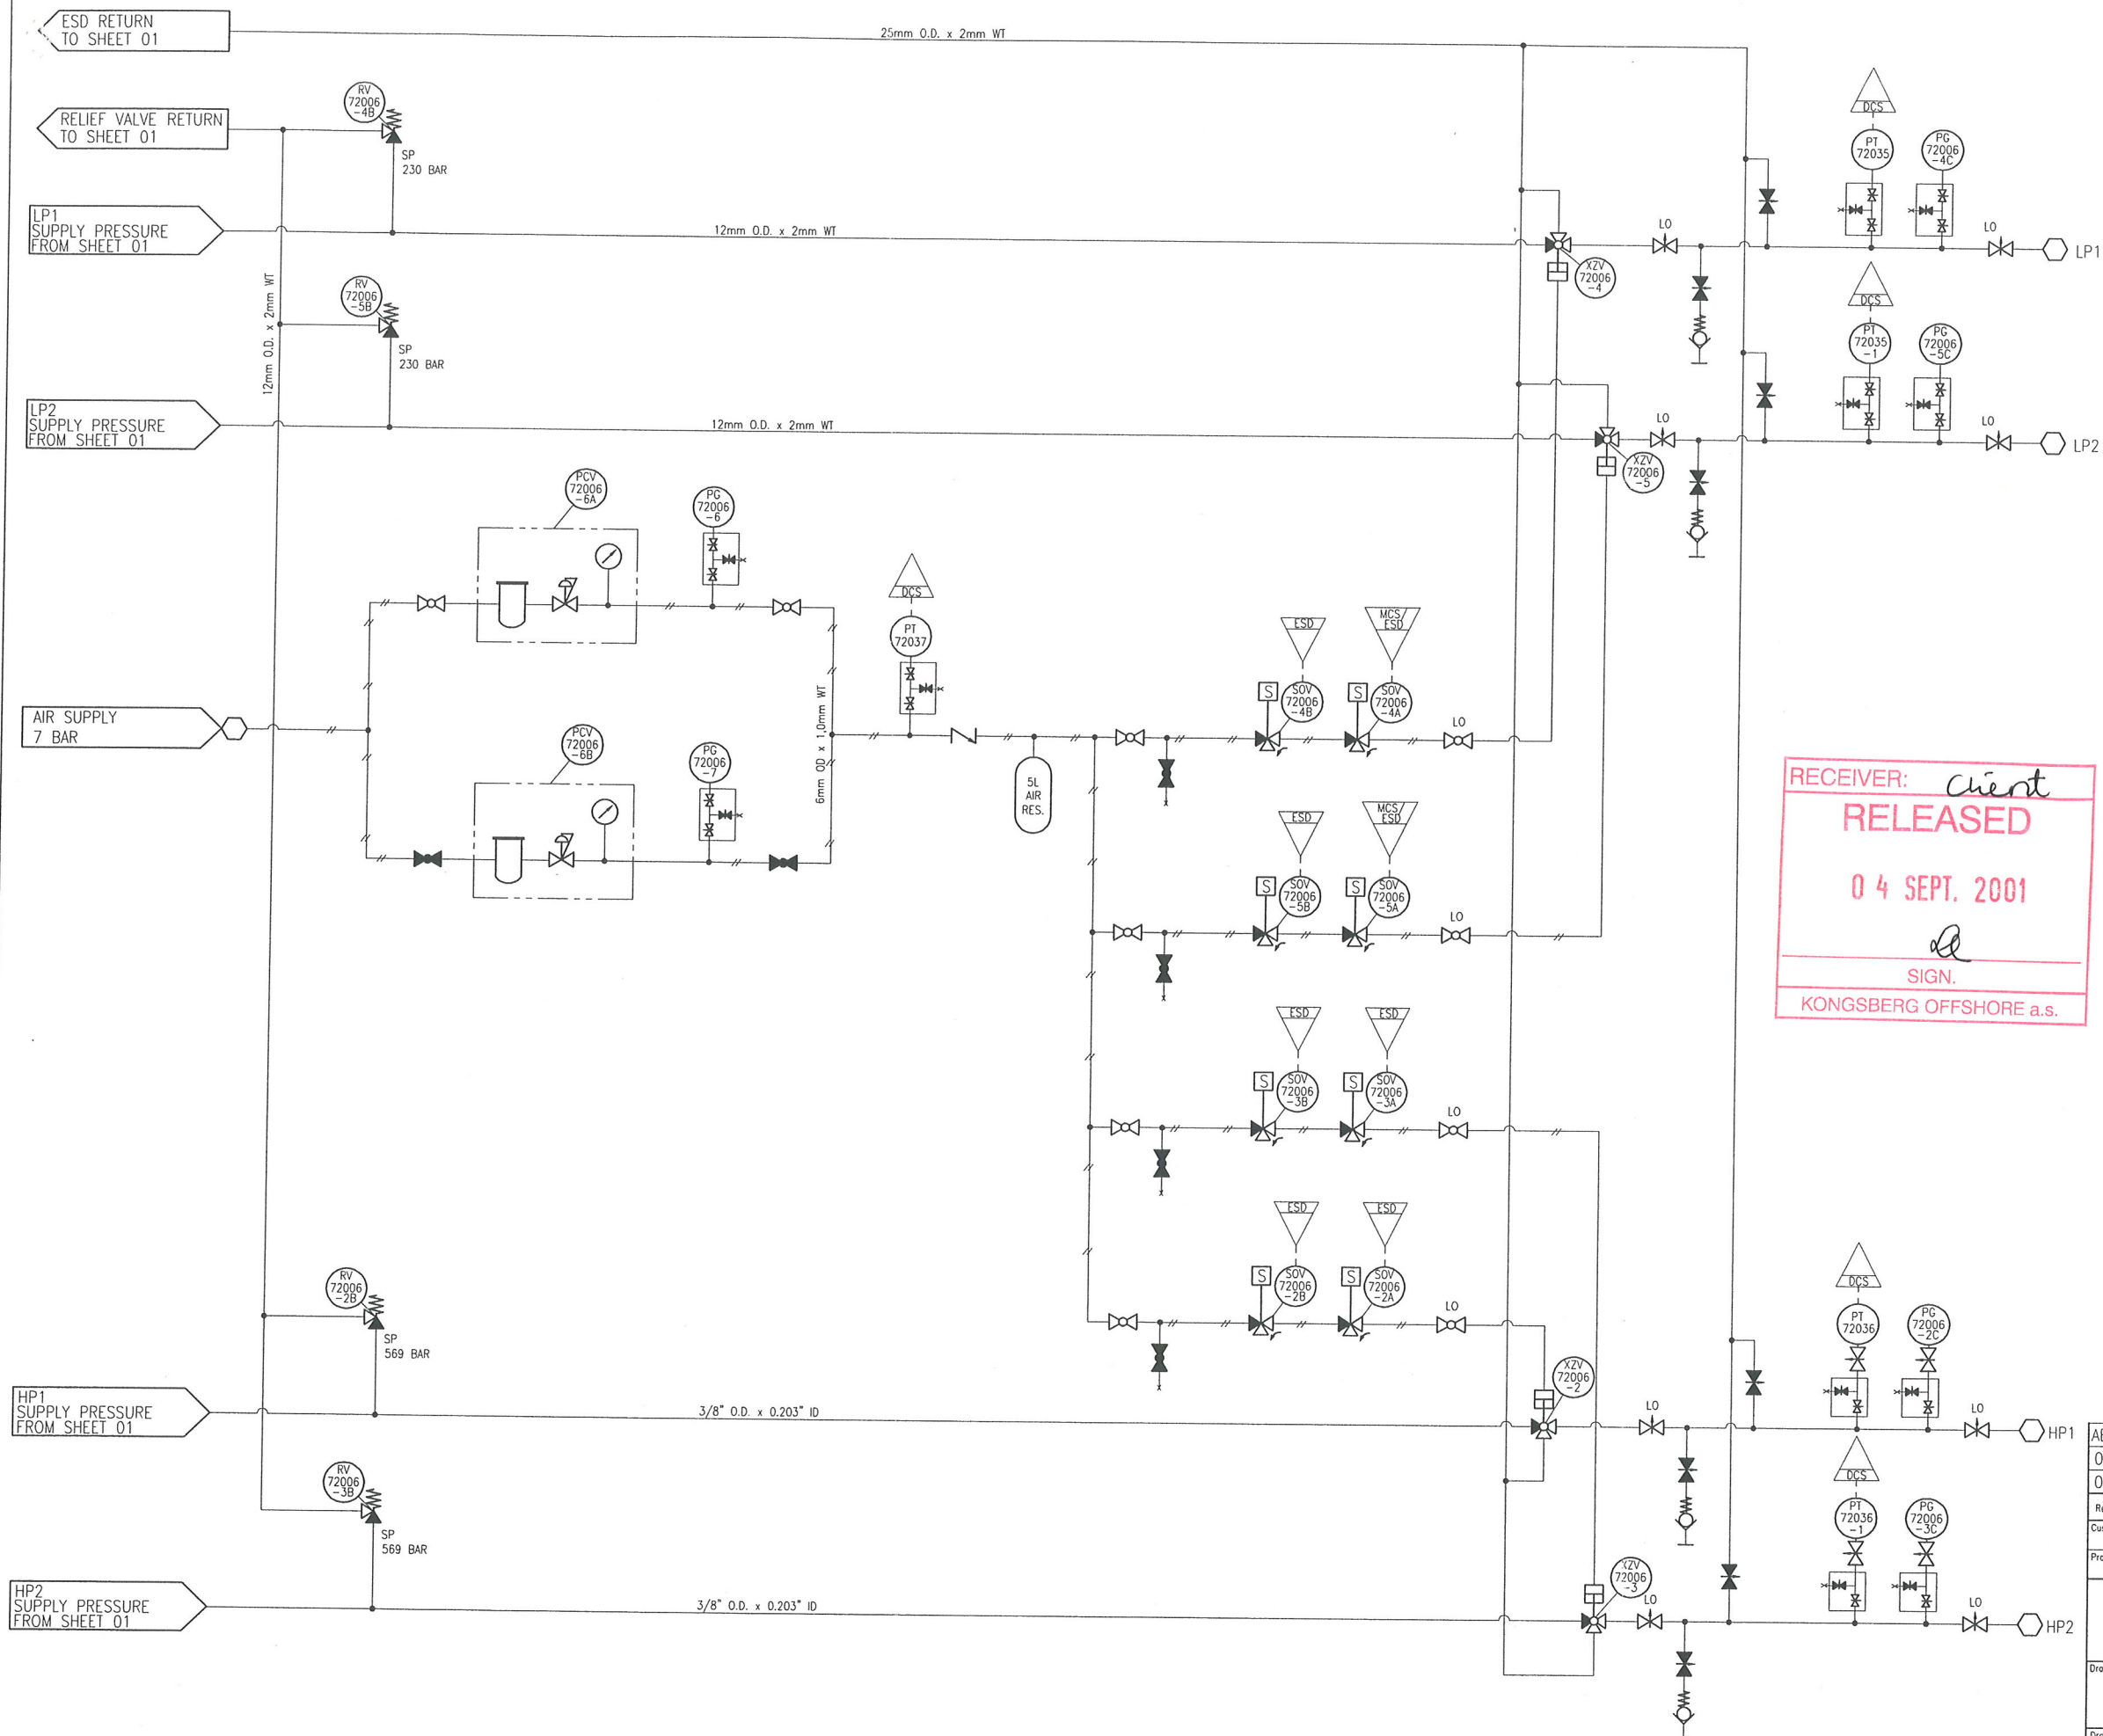


RECEIVER: *Client*
RELEASED
 04 SEPT. 2001
[Signature]
 SIGN.
 KONGSBERG OFFSHORE a.s.

 
NOTES:

REFERENCES:
 DESIGN SPEC. : SPC-0000020465
 LIST OF MATERIAL : 7512-A03-001/LIST-0000020236
 HYDRAULIC SCHEMATIC DIAGRAM : 7512-D02-001/XV-0001000122
 GENERAL ARRANGEMENT : 7512-E01-002/XD-0001000572
 WIRING DIAGRAM, EL. EQUIPMENT : 7512-F03-001/XK-0001000117

ABBREVIATIONS:

LO = VALVE LOCKED OPEN
 LC = VALVE LOCKED CLOSED
 BP = BURST DISC PRESSURE
 SP = SET PRESSURE
 CP = CRACK PRESSURE

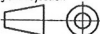1	ABO	22.08.01	AS-BUILT	SMS	OB	JRJ
	01	27.06.01	ISSUED FOR CONSTRUCTION	SMS	PO	RH
	00	20.06.01	ISSUED FOR APPROVAL	SMS	PO	RH
	Rev.	Date	Issue Description	Prep.	Chkd	Appr.
	Customer: FMC KONGSBERG SUBSEA			First Angle Projection		Scale
	Project: OTTER HPU					-
				All dim. in mm		
2				Semco Technology a.s Fabrikkeveien 25. 4065 Stavanger Tel. 51811200 Fax. 51811201		
	Drawing Title P & ID HPU					
	Drawing Size	A1	Dwg No.	7512-I01-001		Sheet 02 of 02 Rev. AB
	01	27.08.01	AS BUILT	SEM	TOHA	JTT
	REV	DATE	DESCRIPTION	DRN	CHK	ENG APP
	TOTAL FINA ELF			OTTER FIELD DEVELOPMENT		
	DRG NO	OTT-U10-PT-80-1068		Contractor	SHT 02	REV 01

ELECTRONIC ORIGINAL User is responsible for verification of correct revision status on document copy	500000006761	Berit Kopseng	27.08.2001	12:44	A
	REL./CHANGE NO.	PREPARED	LAST SAVED (DATE/TIME)		RE
	 (FMC Kongsberg Subsea)			DRAWING NO. XB-0001000090	
	TITLE: HPU P&ID - Otter				
				SHEET 2 OF 2	